

# LA SIERRA STORM CHANNEL

## STAGE "D"

### CONSTRUCTION DRAWINGS


BY

RIVERSIDE COUNTY FLOOD CONTROL  
AND

WATER CONSERVATION DISTRICT


### GENERAL NOTES

1. Reinforced concrete shall be Class A (6 sack) and shall have a minimum of 3,000 p.s.i. 28 day compressive strength.
2. Reinforcing steel shall be deformed, intermediate grade, billet-steel bars conforming to the specifications of A.S.T.M. Designation A-15, latest revised, with deformations conforming to A.S.T.M. Designation A-305.
3. All reinforcing bar bends and hooks shall conform to the American Concrete Institute "MANUAL of STANDARD PRACTICE."
4. Lap all reinforcing steel a minimum of 30 bar diameters at splices. The location of all splices shall be subject to approval of the Engineer.
5. All reinforcing steel shall have a minimum cover of 1 1/2" unless otherwise noted.
6. All exposed edges of concrete structures shall be chamfered 3/4" or rounded as directed.
7. All concrete thickness dimensions are the minimum allowable.
8. Transverse construction joints at 50' spacing, or as directed by the Engineer, shall be provided in the reinforced concrete channel lining.
9. Approved broken rock or gravel, well graded from 3/8 inch to 3/4 inch in size, shall be used for subdrainage filter material.
10. The backfill for the concrete channel shall be compacted to not less than 85% maximum density, and the backfill for the R.C.B. culverts shall be compacted to not less than 90% maximum density as determined by tests made conforming to the requirements of test Method No. Calif. 216 - F.
11. For Right of Way Data refer to Record of Survey Book 40 Pages 92 to 94.

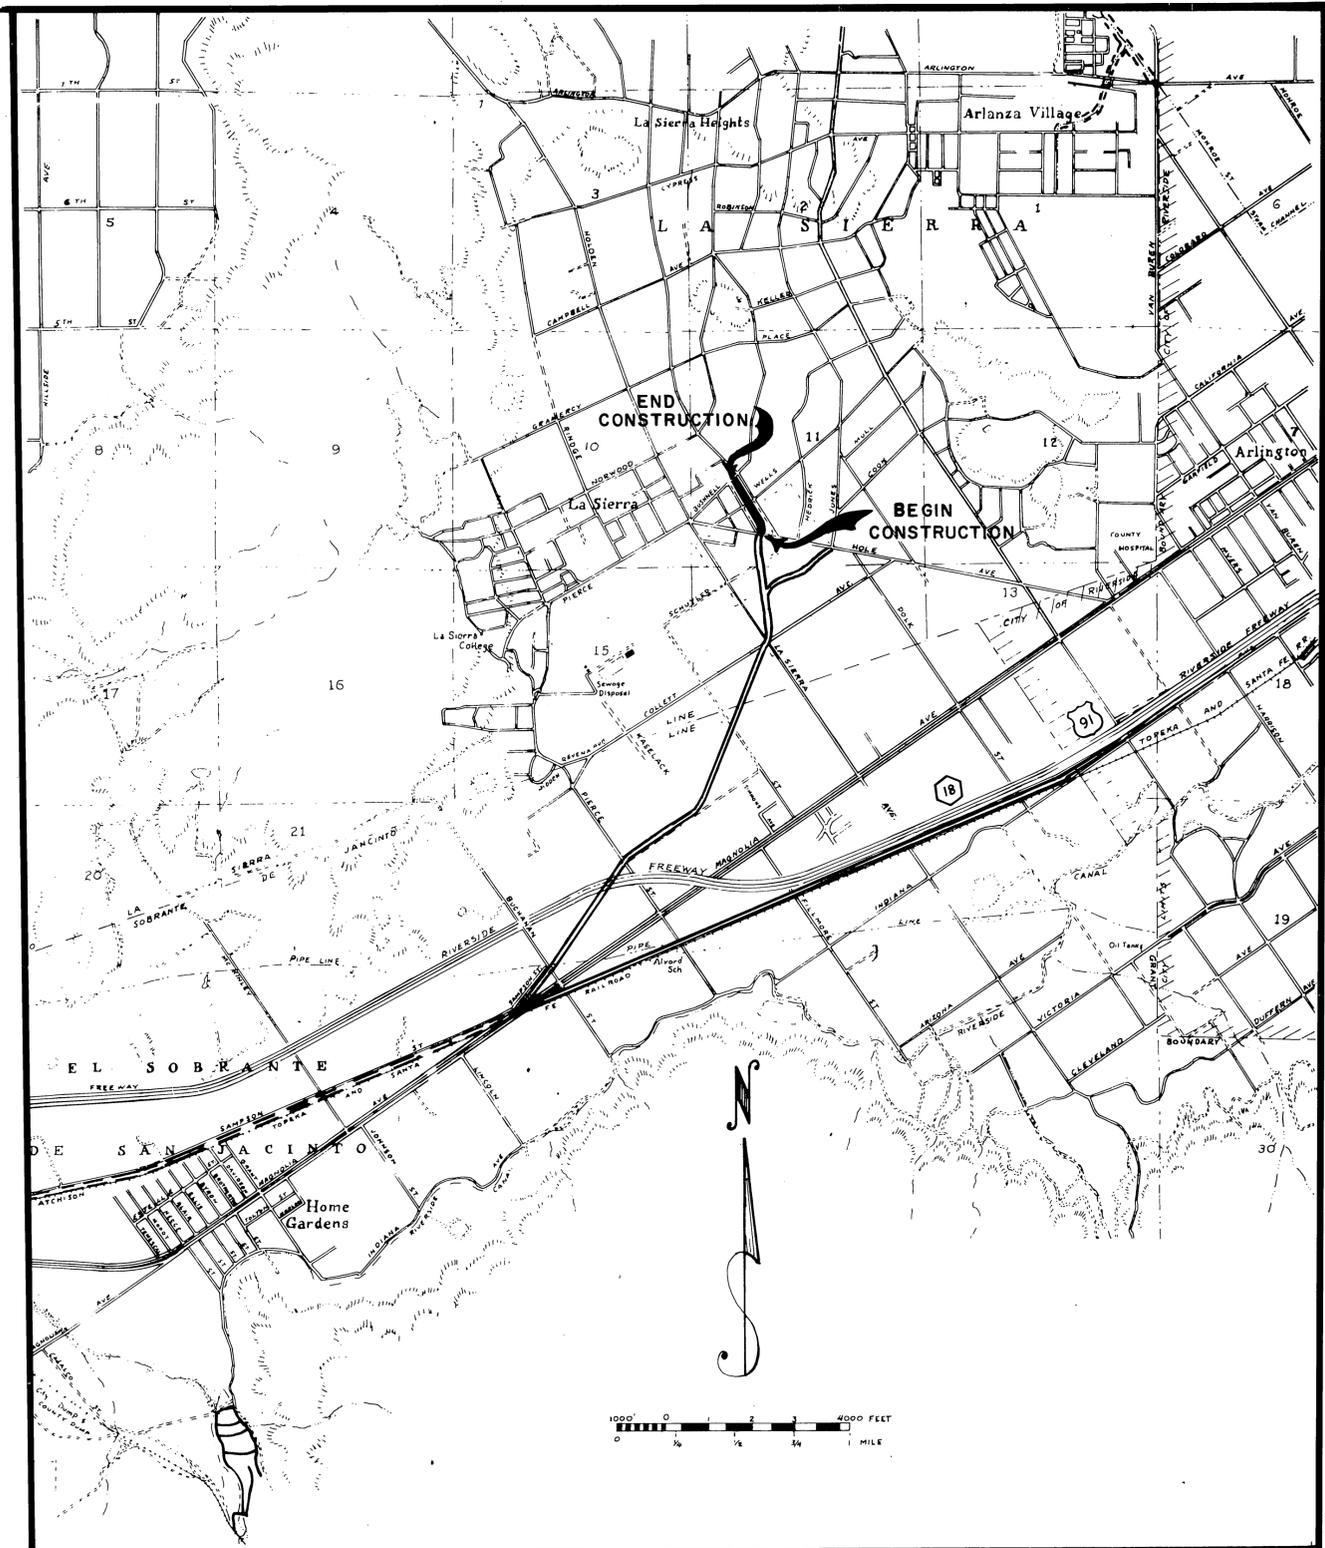



AS BUILT  
PROJECT NO. 1-0-060

RIVERSIDE COUNTY FLOOD CONTROL AND WATER CONSERVATION DISTRICT			
LA SIERRA STORM CHANNEL STAGE "D"			
COVER SHEET			
REVISED DATE	DRAWN: K. D. BISHOP	CHECKER: P. M. MOON	DATE DRAWN: MAY, 1963
APPROVED: [Signature]	ENGINEER: [Signature]	CHECKER: P. M. MOON	DATE DRAWN: MAY, 1963

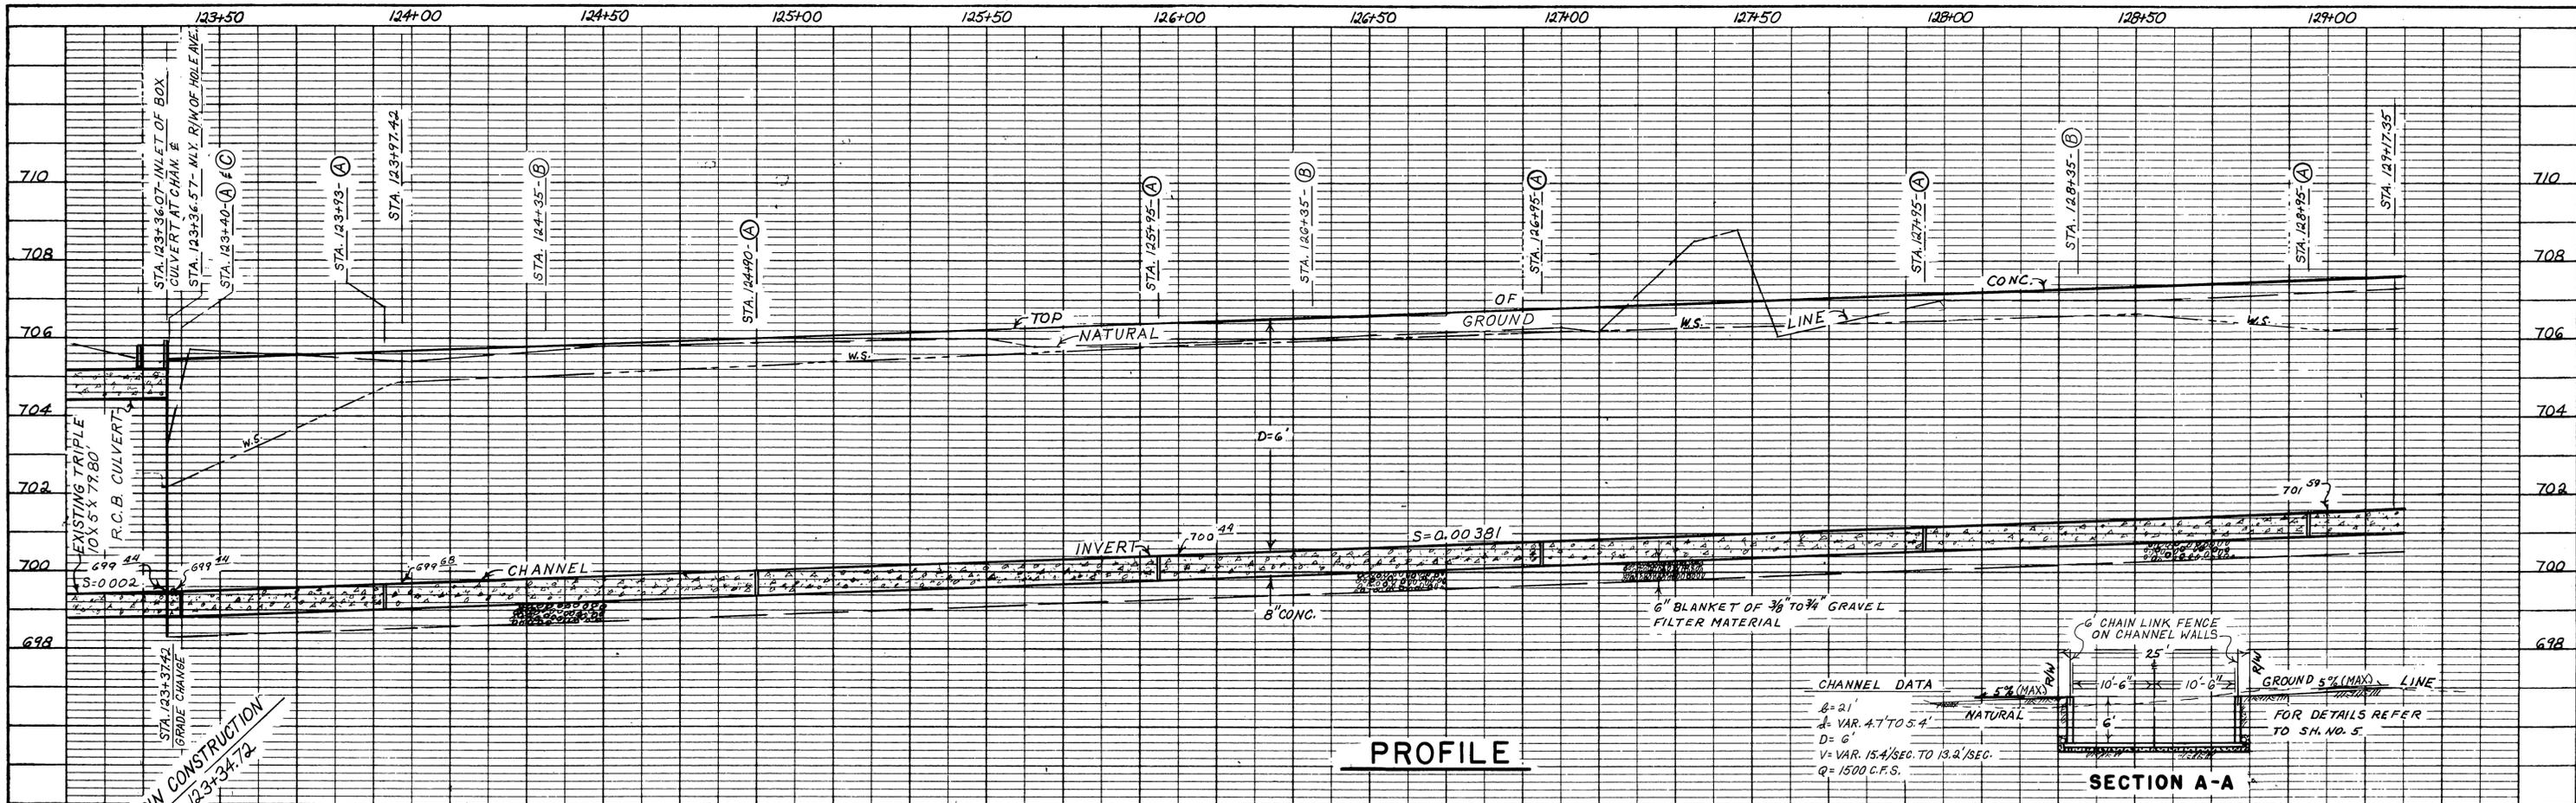

**CHANNEL DATA**

B = 21'  
 d = VAR. 4.7' TO 5.4'  
 D = 6'  
 V = VAR. 15.4'/SEC. TO 13.2'/SEC.  
 Q = 1500 C.F.S.

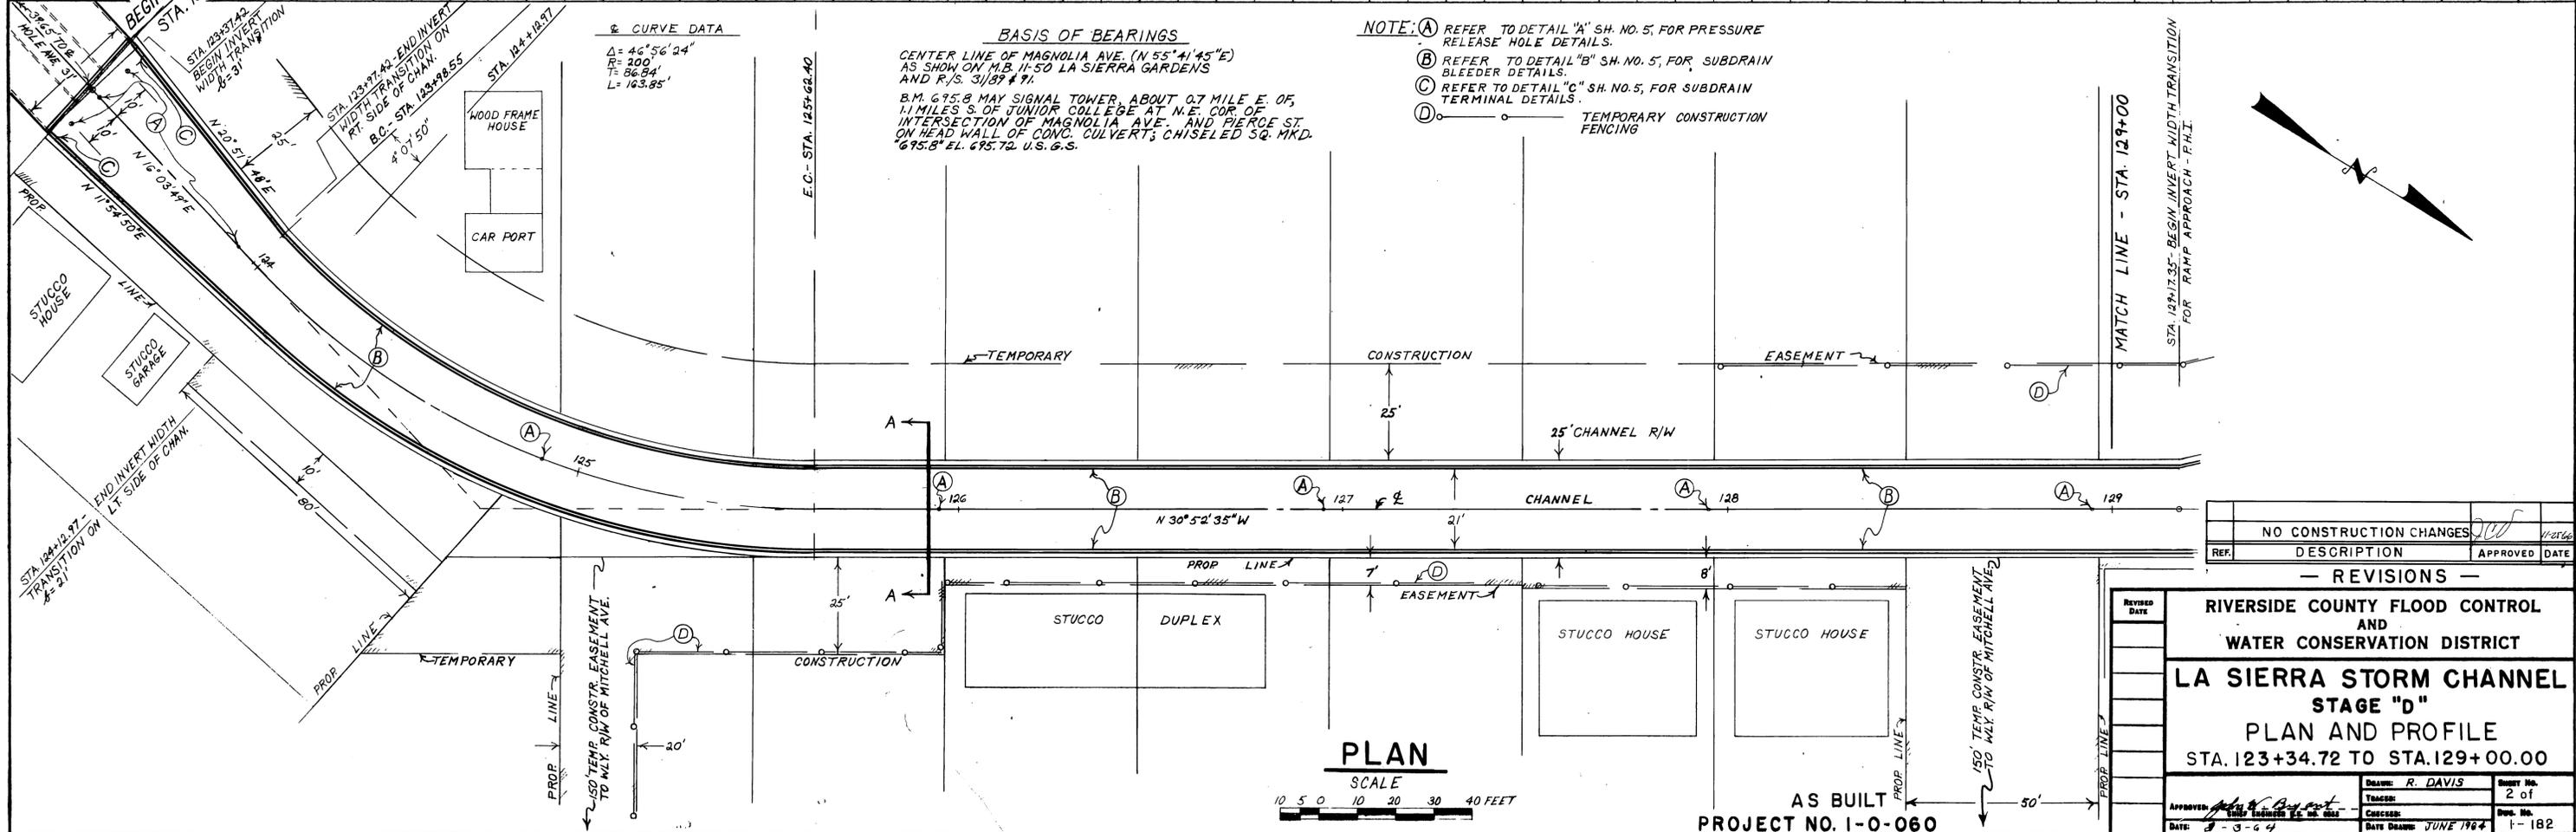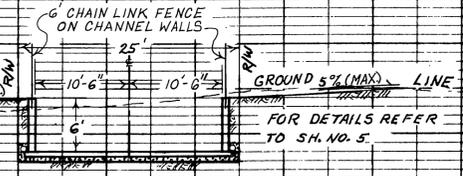

**CURVE DATA**

$\Delta = 46^\circ 56' 24''$   
 $R = 200'$   
 $T = 86.84'$   
 $L = 163.85'$

**BASIS OF BEARINGS**

CENTER LINE OF MAGNOLIA AVE. (N 55° 41' 45" E)  
 AS SHOWN ON M.B. 11-50 LA SIERRA GARDENS  
 AND R/S. 3/1/87 & 91.

B.M. 695.8 MAY SIGNAL TOWER, ABOUT 0.7 MILE E. OF,  
 1.1 MILES S. OF JUNIOR COLLEGE AT N.E. COR. OF  
 INTERSECTION OF MAGNOLIA AVE. AND PIERCE ST.  
 ON HEAD WALL OF CONC. CULVERT; CHISELED SQ. MKD.  
 695.8' EL. 695.72 U.S.G.S.

- NOTE:**
- (A) REFER TO DETAIL "A" SH. NO. 5, FOR PRESSURE RELEASE HOLE DETAILS.
  - (B) REFER TO DETAIL "B" SH. NO. 5, FOR SUBDRAIN BLEEDER DETAILS.
  - (C) REFER TO DETAIL "C" SH. NO. 5, FOR SUBDRAIN TERMINAL DETAILS.
  - (D) ———— TEMPORARY CONSTRUCTION FENCING

**PLAN**

SCALE  
 1" = 20'

NO CONSTRUCTION CHANGES	APPROVED	DATE
DESCRIPTION		

— REVISIONS —



**RIVERSIDE COUNTY FLOOD CONTROL AND WATER CONSERVATION DISTRICT**

**LA SIERRA STORM CHANNEL STAGE "D"**

**PLAN AND PROFILE**

STA. 123+34.72 TO STA. 129+00.00

APPROVED: <i>[Signature]</i>	DESIGNED: R. DAVIS	DRAWN: R. DAVIS
CHECKED: <i>[Signature]</i>	TRACED: <i>[Signature]</i>	DATE: 6-9-84
DATE: 6-9-84	DATE DRAWN: JUNE 1984	PROJECT NO. 1-0-060

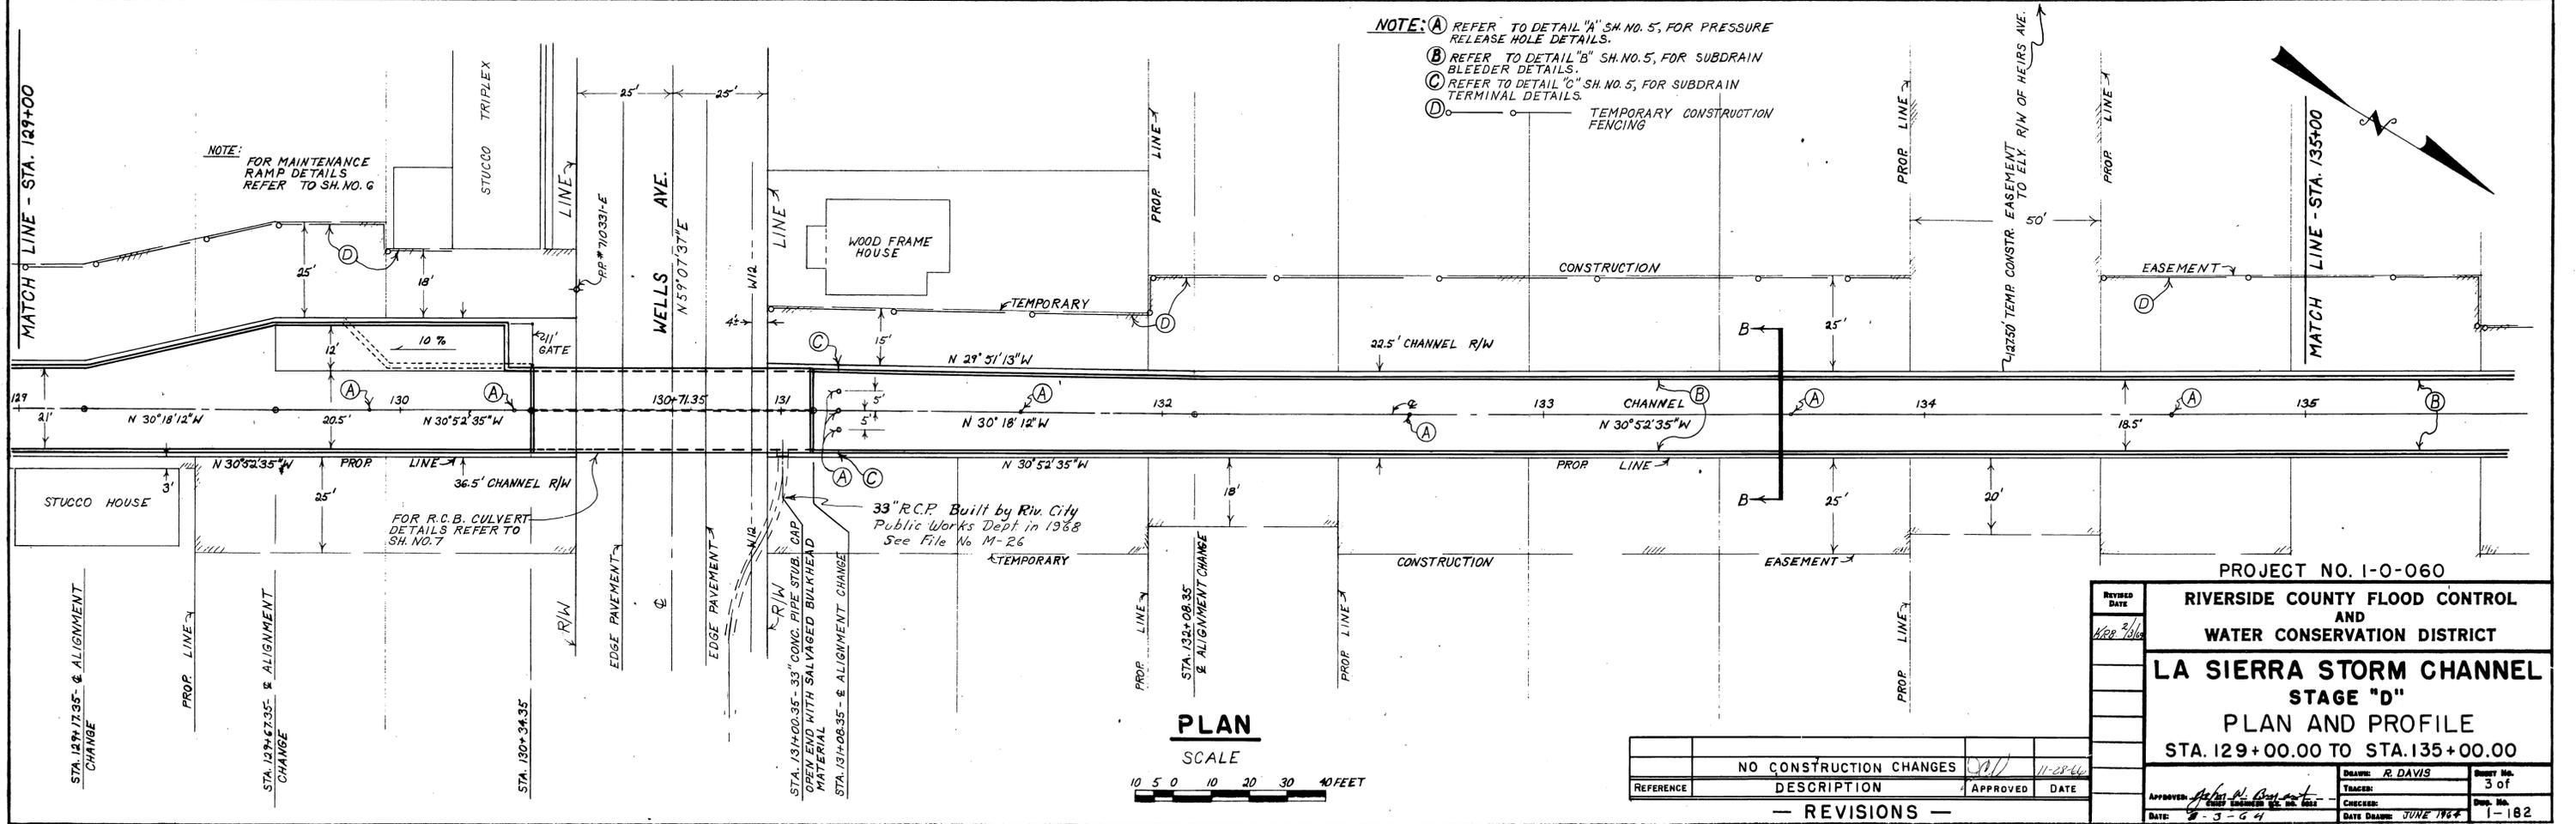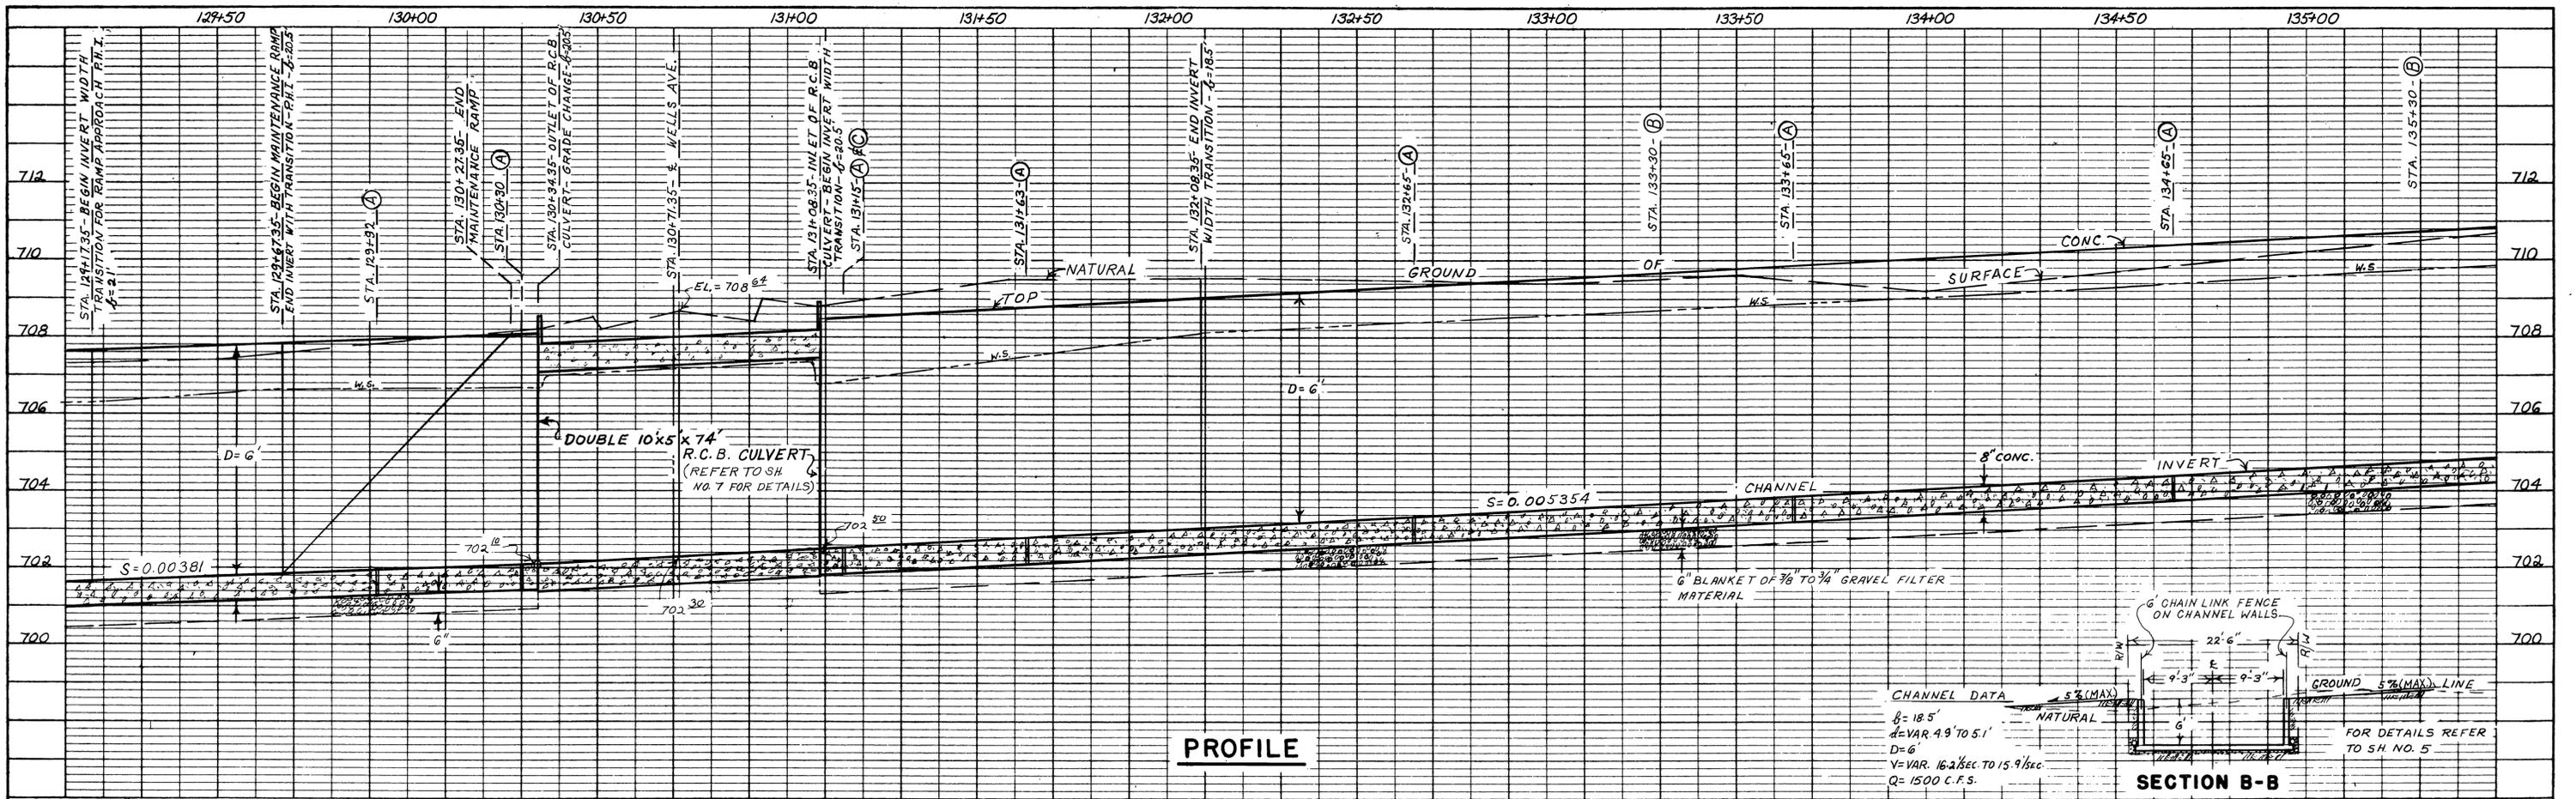

REFERENCE	DESCRIPTION	APPROVED	DATE
	NO CONSTRUCTION CHANGES	<i>[Signature]</i>	11-28-66

— REVISIONS —

AS BUILT

PROJECT NO. 1-0-060

RIVERSIDE COUNTY FLOOD CONTROL AND WATER CONSERVATION DISTRICT

**LA SIERRA STORM CHANNEL**



STAGE "D"

PLAN AND PROFILE

STA. 129+00.00 TO STA. 135+00.00

REVISED DATE	None
DATE	6-3-64
DRAWN	R. DAVIS
TRACED	
CHECKED	
DATE DRAWN	JUNE 1964
SHEET No.	3 of 3
PROJ. No.	1-182

D-173D

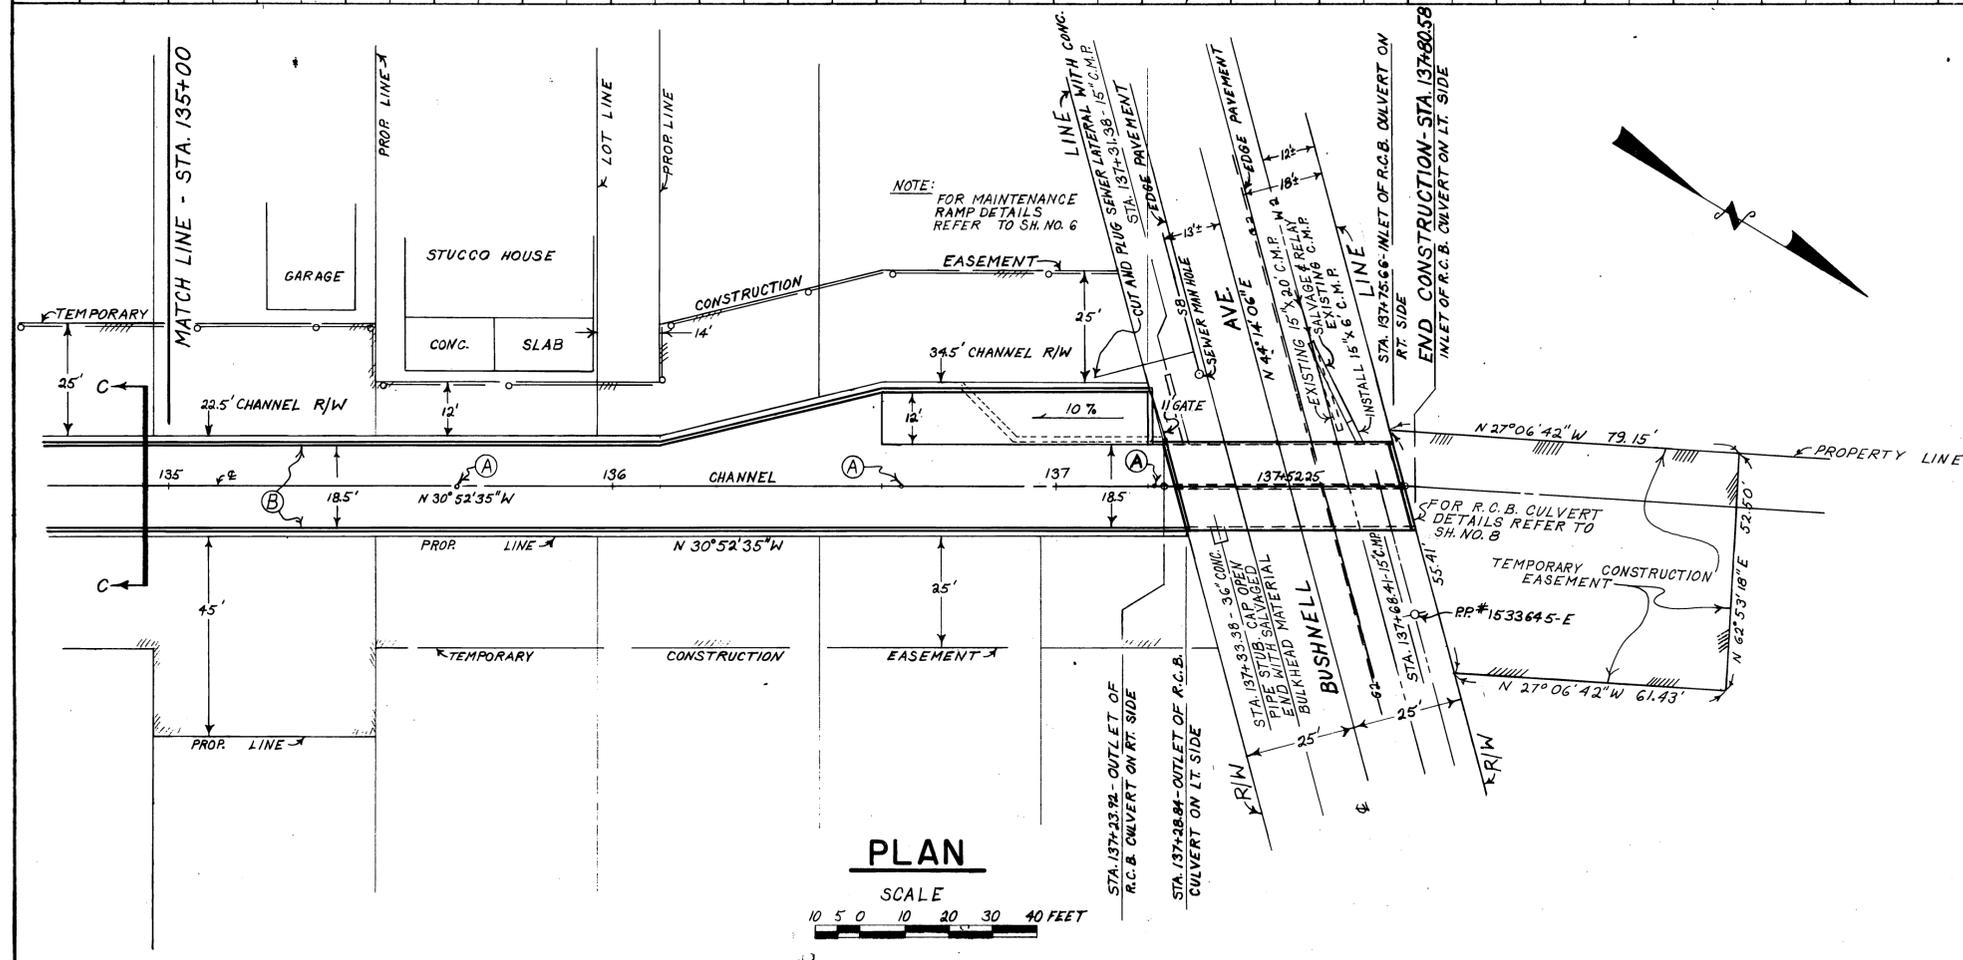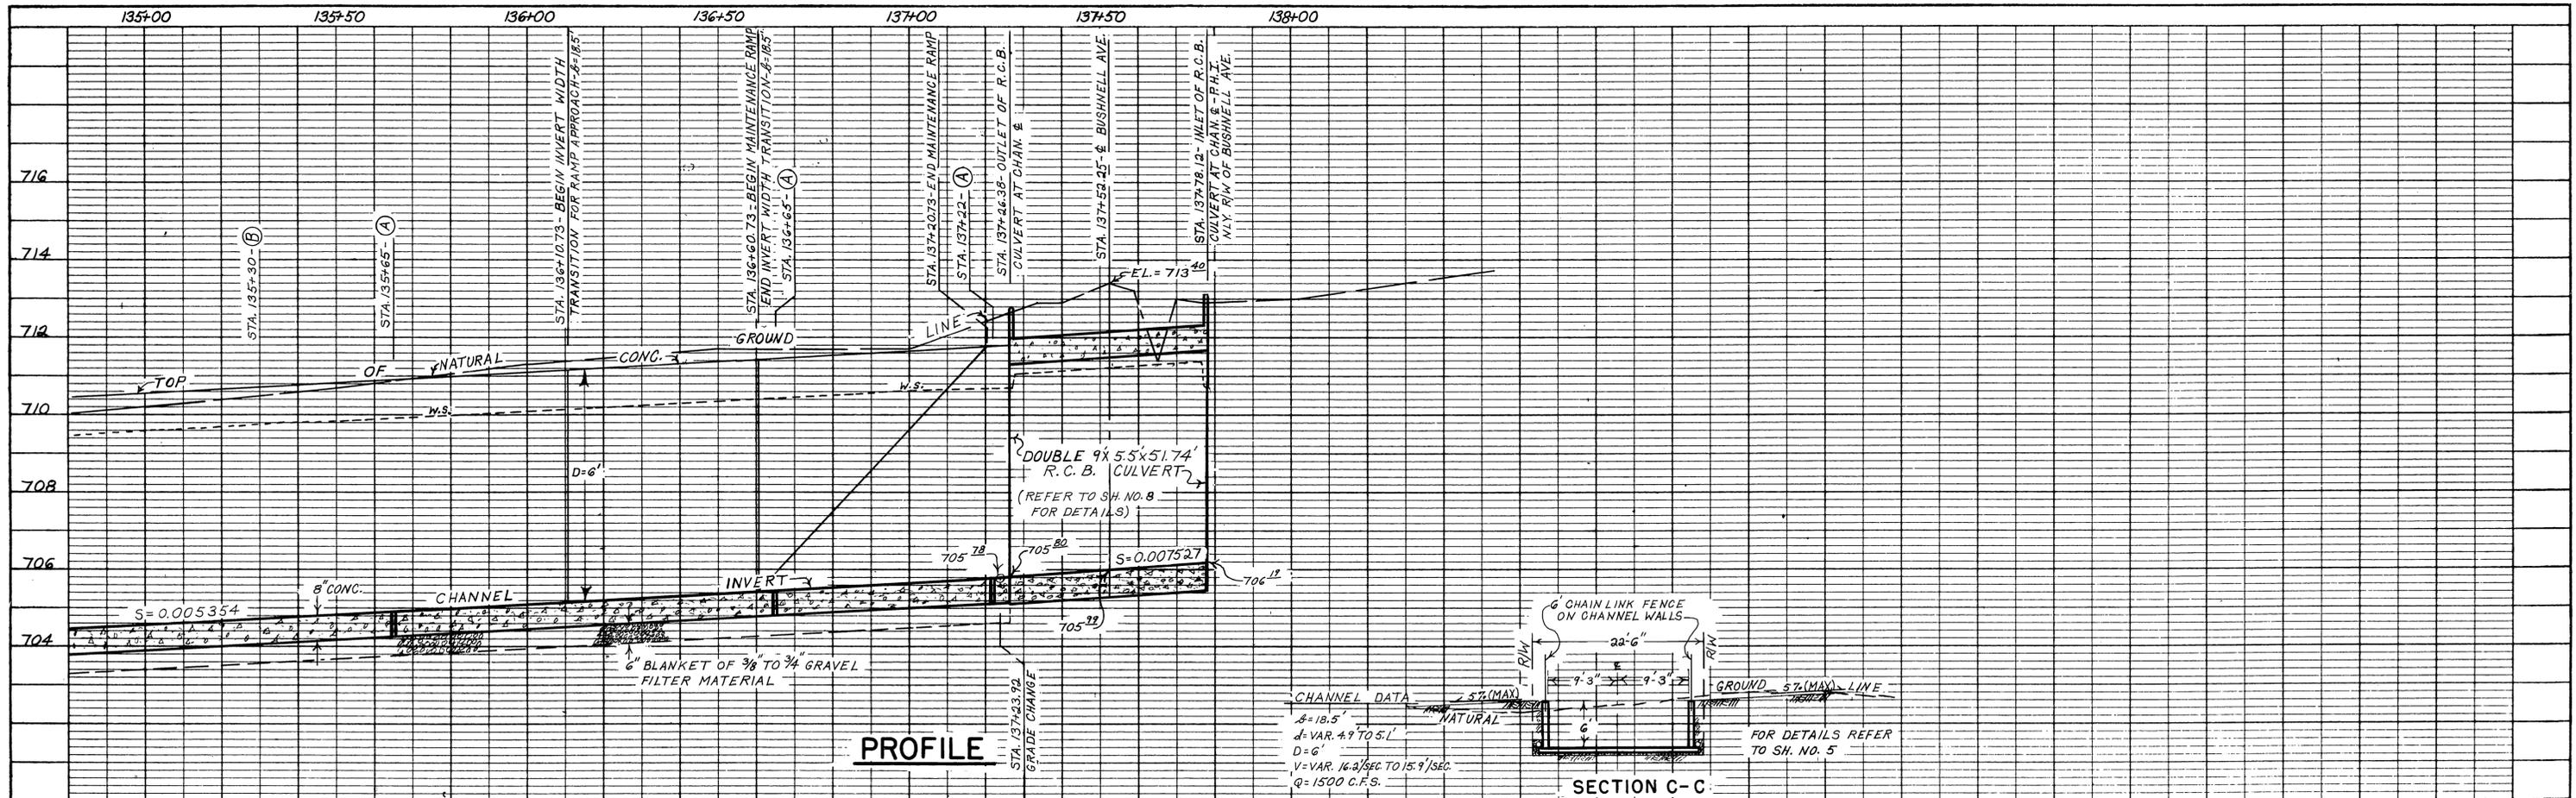


NOTE: (A) REFER TO DETAIL "A" SH. NO. 5, FOR PRESSURE RELEASE HOLE DETAILS.  
 (B) REFER TO DETAIL "B" SH. NO. 5, FOR SUBDRAIN BLEEDER DETAILS.  
 (C) TEMPORARY CONSTRUCTION FENCING

**PLAN**  
 SCALE  
 0 5 10 20 30 40 FEET


AS BUILT  
 PROJECT NO. 1-0-060

NO CONSTRUCTION CHANGES	APPROVED	DATE
DESCRIPTION	APPROVED	DATE
— REVISIONS —		
REVISED DATE	RIVERSIDE COUNTY FLOOD CONTROL AND WATER CONSERVATION DISTRICT	
LA SIERRA STORM CHANNEL		
STAGE "D"		
PLAN AND PROFILE		
STA. 135+00.00 TO STA. 137+80.58		
APPROVED: <i>[Signature]</i>	DRAWN: R. DAVIS	REVISION: 4 of 4
CHECKED: <i>[Signature]</i>	DATE: JUNE 1982	DATE: 1-10-82

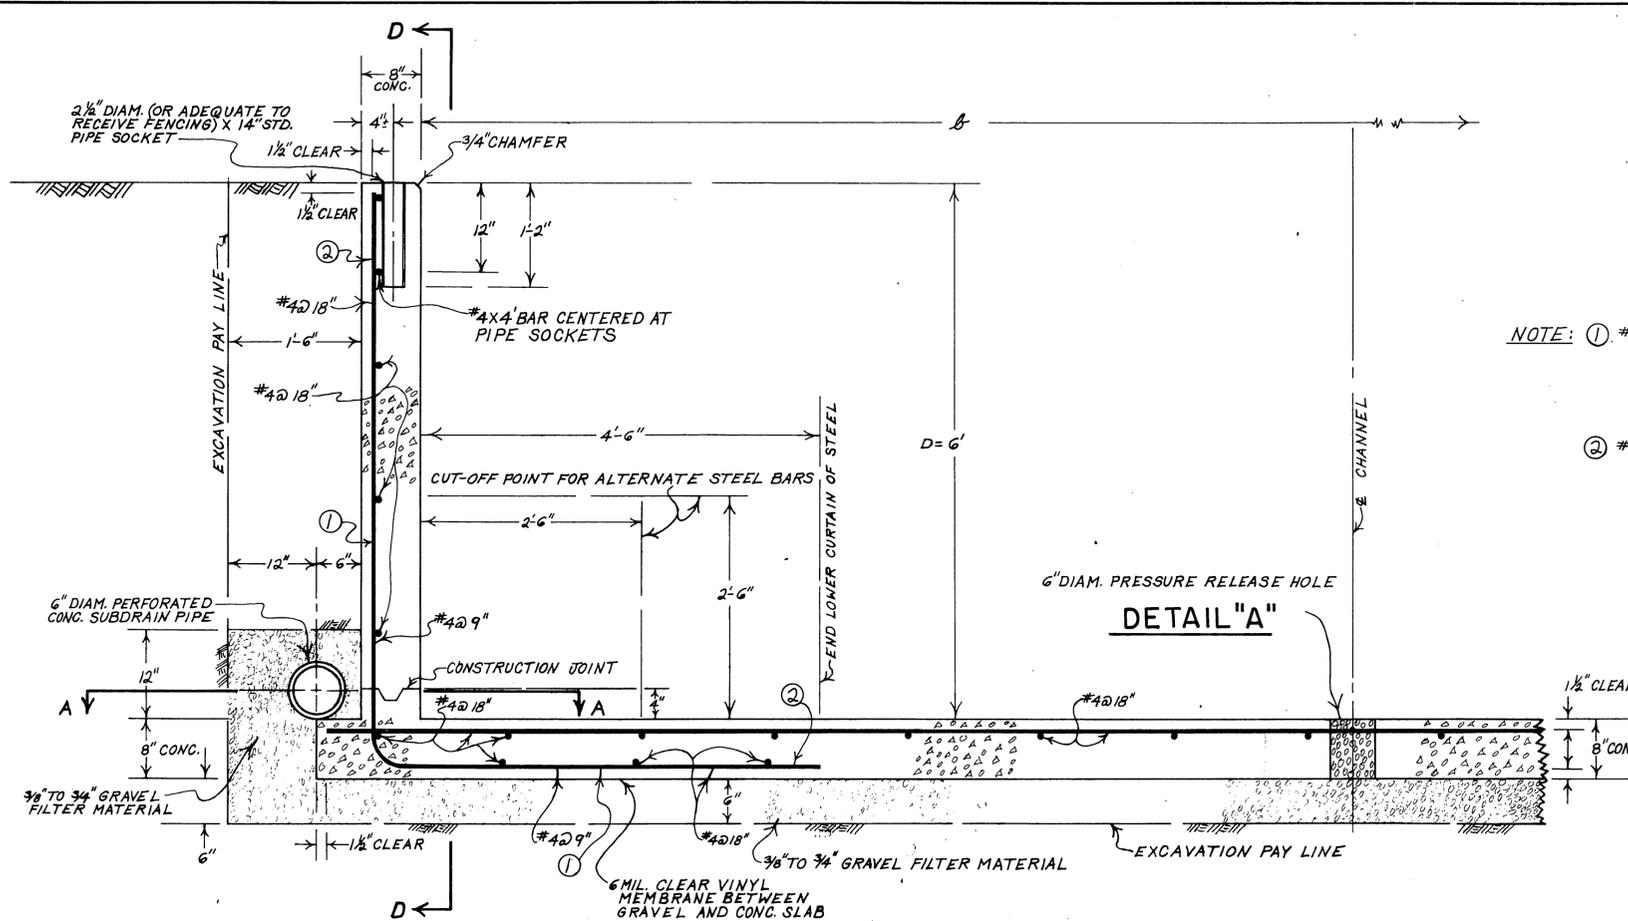


TYPICAL CHANNEL SECTION  
SYMMETRICAL ABOUT C-C


NOTE: ① #4 BAR: 3'  
② #4 BAR: 5'

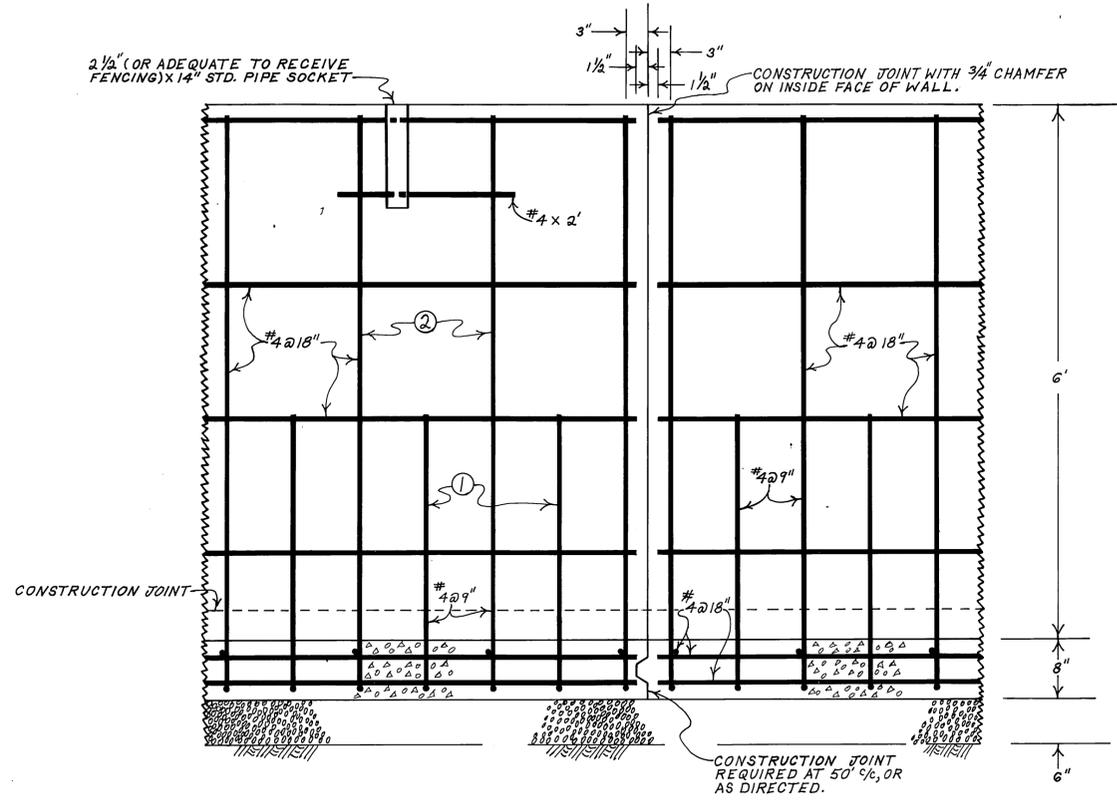


SECTION D-D

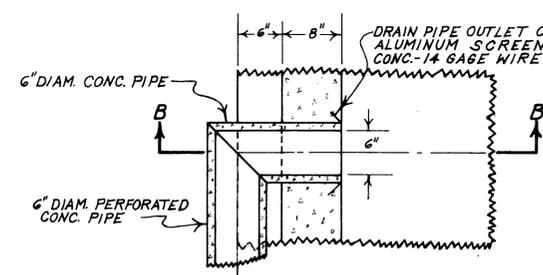


SECTION A-A

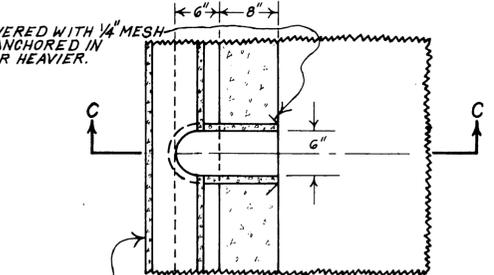

SECTION A-A

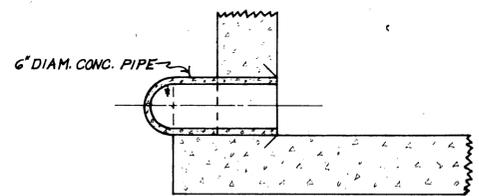


SECTION B-B

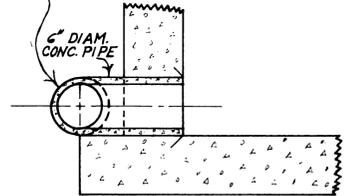


SECTION C-C

TYPICAL SUBDRAIN TERMINAL DETAILS  
DETAIL "C"


TYPICAL SUBDRAIN BLEEDER DETAILS  
DETAIL "B"  
BOTH WALLS OF CHANNEL 200%

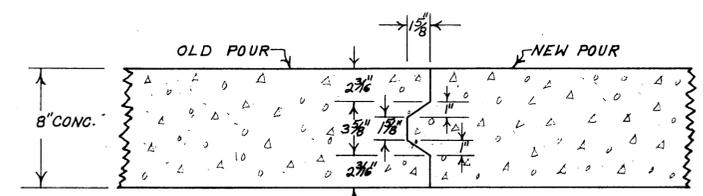


CONSTRUCTION JOINT  
TYPICAL FOR CHANNEL INVERT AND WALLS

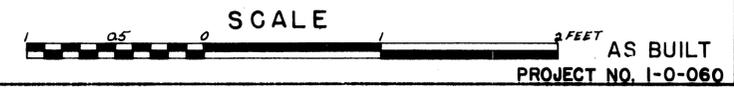

NO CONSTRUCTION CHANGES	APPROVED	DATE
DESCRIPTION	APPROVED	DATE
- REVISIONS -		
RIVERSIDE COUNTY FLOOD CONTROL AND WATER CONSERVATION DISTRICT		
LA SIERRA STORM CHANNEL STAGE "D"		
CHANNEL DETAILS		
REVISION DATE	DRAWN: R. DAVIS	SHEET NO. 5
APPROVED: [Signature]	CHECKED:	DWG. NO. 1-182
DATE: 8-3-64	DATE DRAWN: JULY 1964	

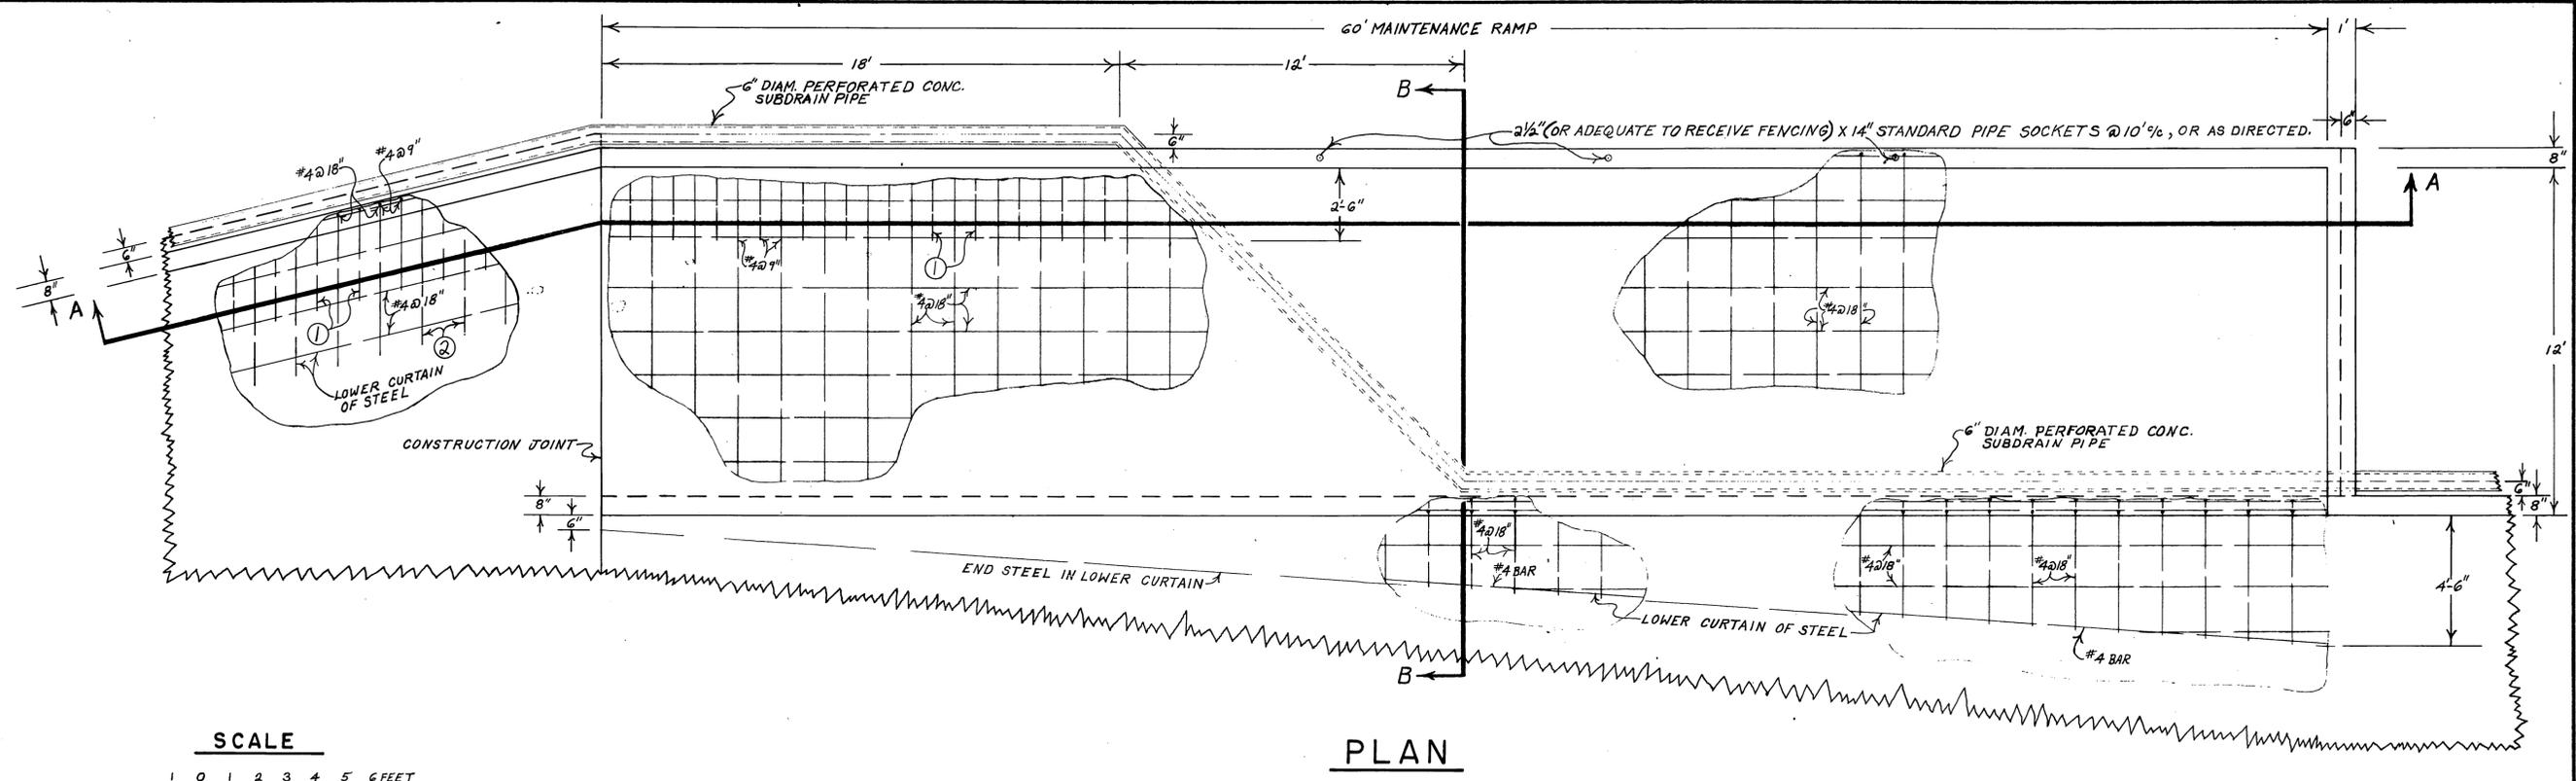


PLAN

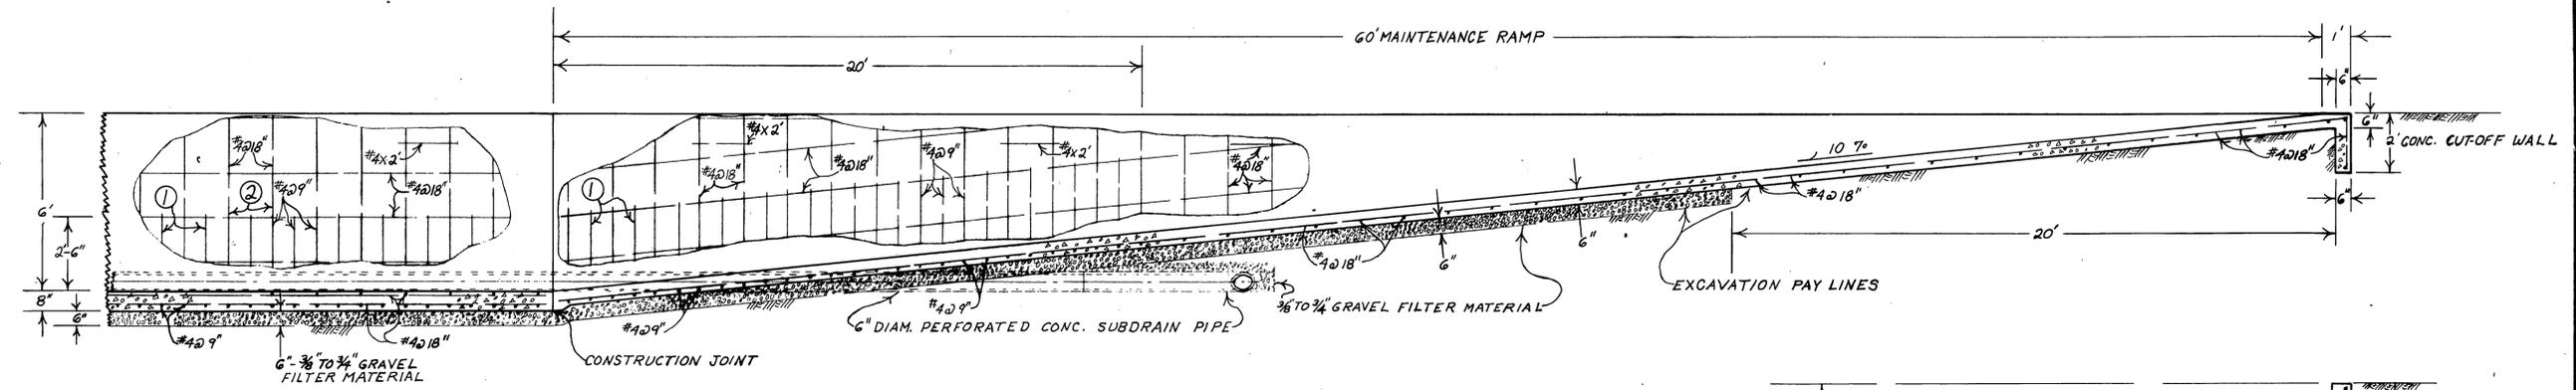

SECTION A-A






NOTE: ① #4 BAR: 3'  
 ② #4 BAR: 6'-5"

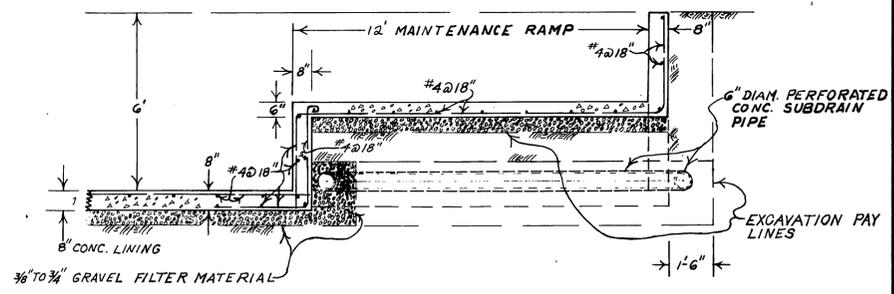

SECTION B-B PROJECT NO. I-0-060

RIVERSIDE COUNTY FLOOD CONTROL AND WATER CONSERVATION DISTRICT		
LA SIERRA STORM CHANNEL STAGE "D"		
MAINTENANCE RAMP DETAILS		
APPROVED: <i>[Signature]</i>	DESIGNED: R. DAVIS	DRAWN: No. 6
DATE: 2-3-63	CHECKED: [Signature]	DATE: MAY 1962
NO CONSTRUCTION CHANGES	APPROVED: [Signature]	DATE: 4-3-66
REFERENCE	DESCRIPTION	APPROVED DATE

- REVISIONS - AS BUILT

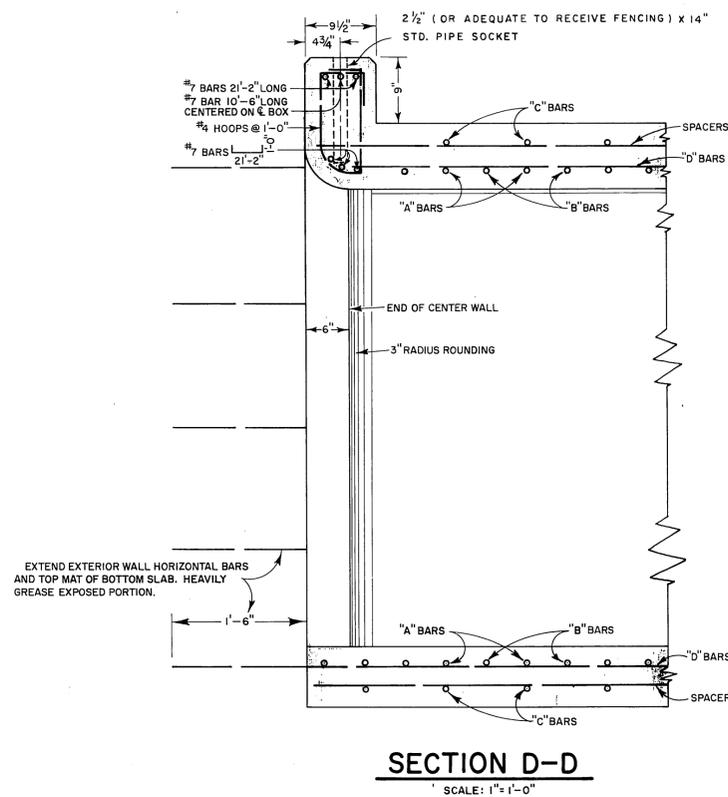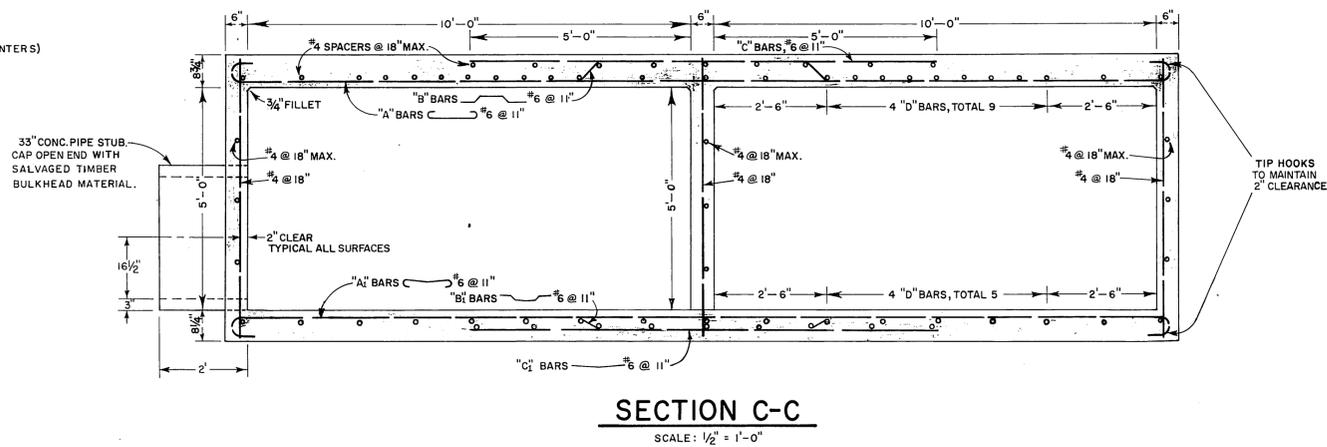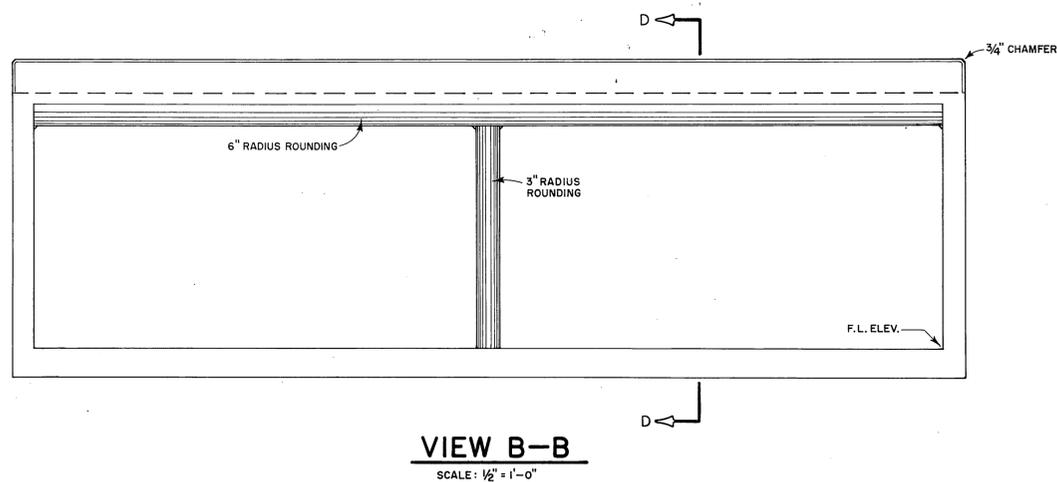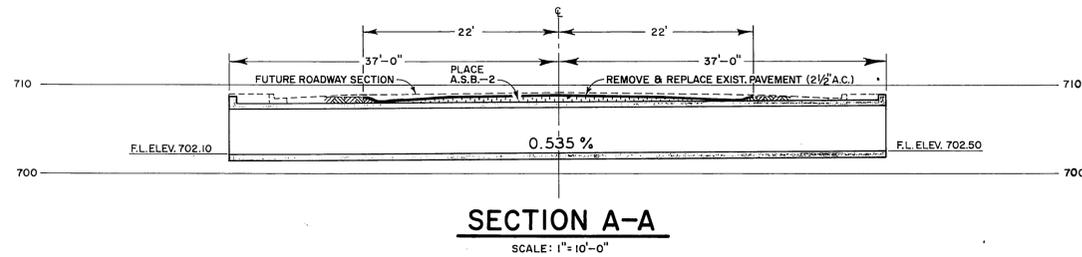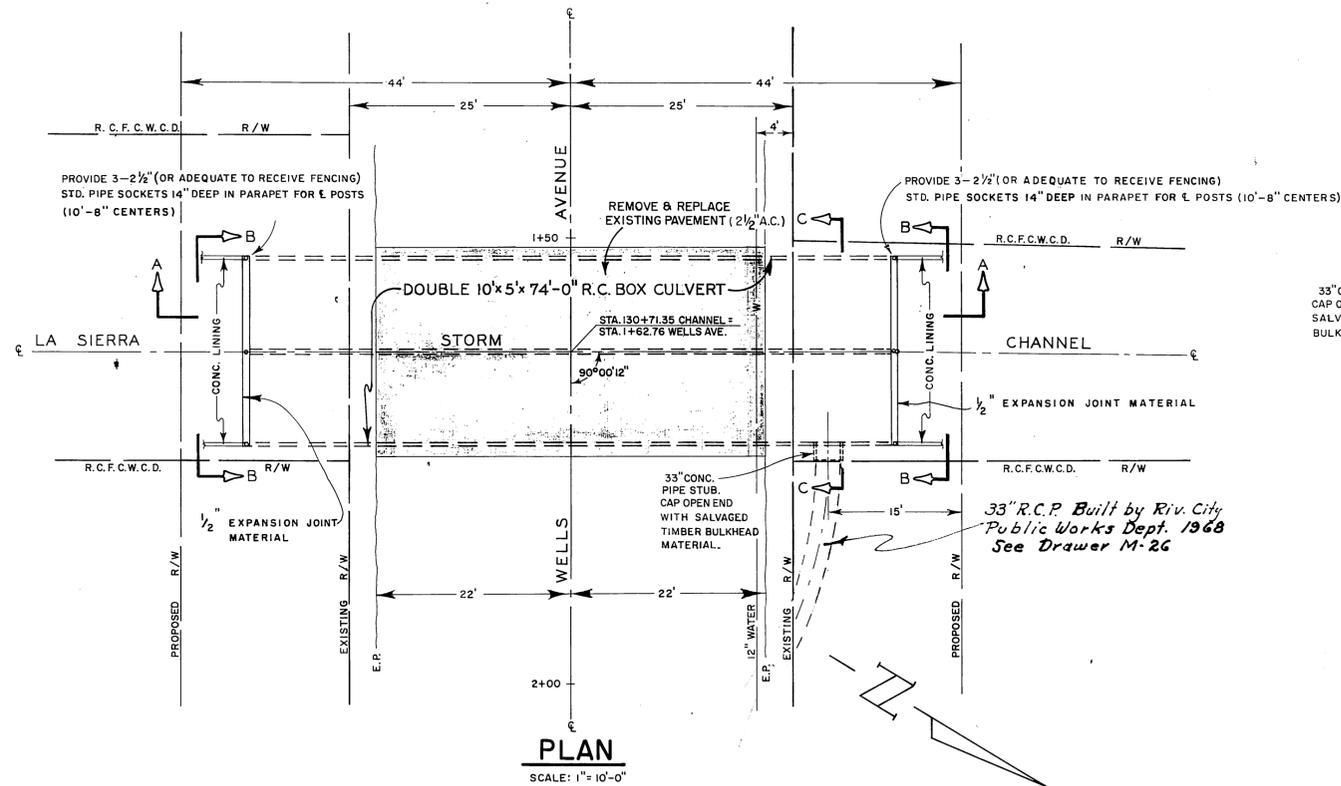

AS BUILT  
PROJECT NO. I-0-060

APPROVED: *[Signature]*  
COUNTY ROAD COMMISSIONER  
DATE: March 2, 1964

REFERENCE	DESCRIPTION	APPROVED	DATE
	NO CONSTRUCTION CHANGES	<i>[Signature]</i>	11-23-66


— REVISIONS —

RIVERSIDE COUNTY FLOOD CONTROL  
AND  
WATER CONSERVATION DISTRICT


DETAILS  
R.C. BOX CULVERT  
STA. 130+71.35

REVISION	DATE	BY	DATE
APPROVED: <i>[Signature]</i> ENGINEER R.E. NO. 8922	DATE: 11-9-64	DRAWN BY: <i>[Signature]</i> RIV. CO. ROAD DEPT.	CHECKED BY: <i>[Signature]</i> DATE DRAWN:


SHEET No. 7  
DR. No. I-182

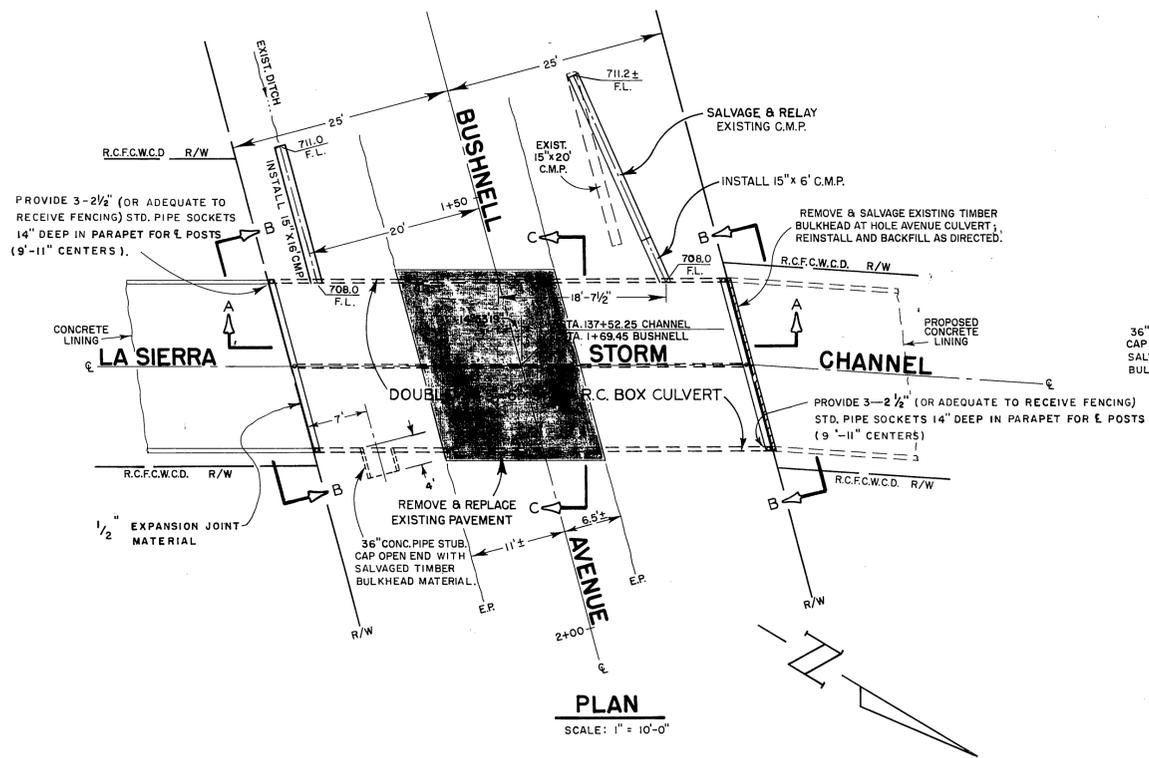


**PLAN**  
SCALE: 1" = 10'-0"

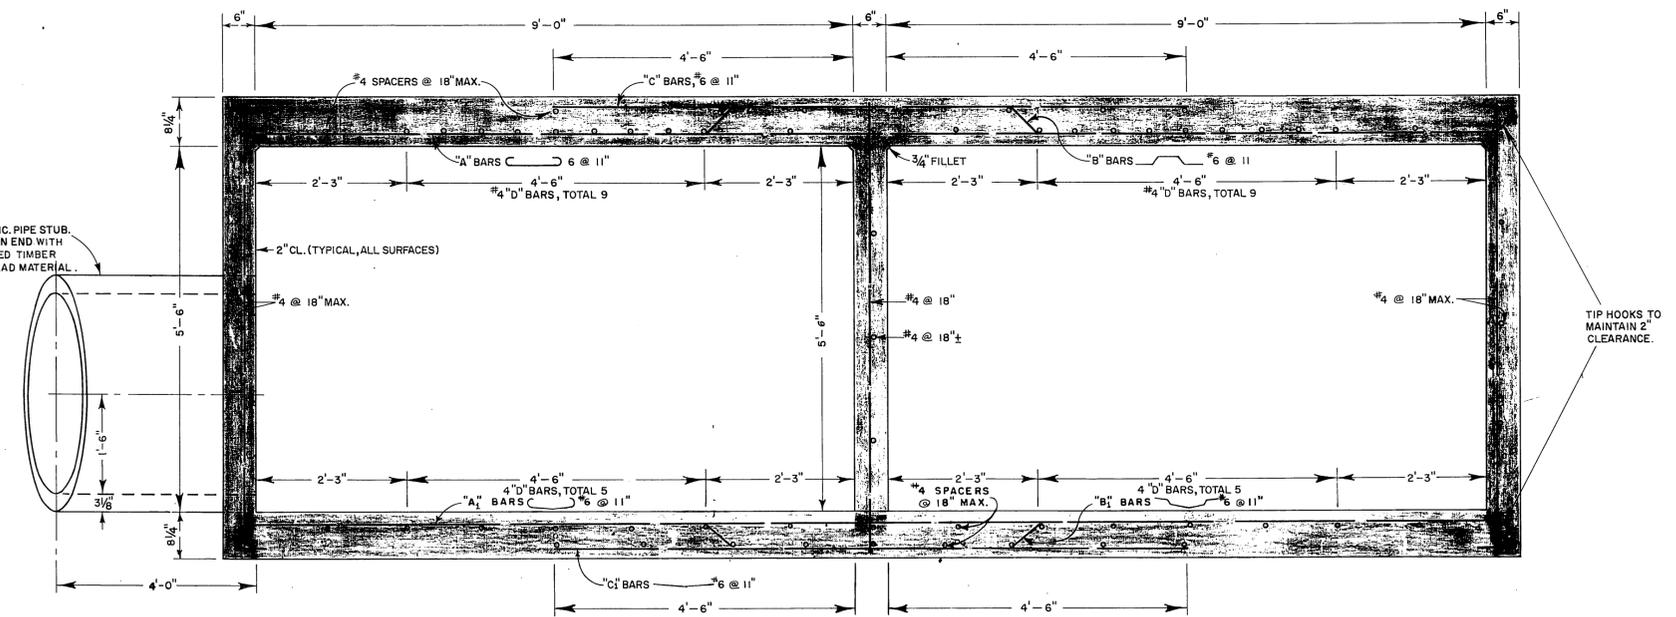


**SECTION C-C**  
SCALE: 3/4" = 1'-0"

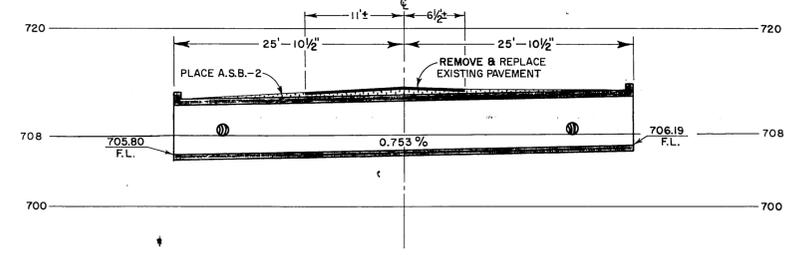

**SECTION A-A**  
SCALE: 1" = 10'-0"

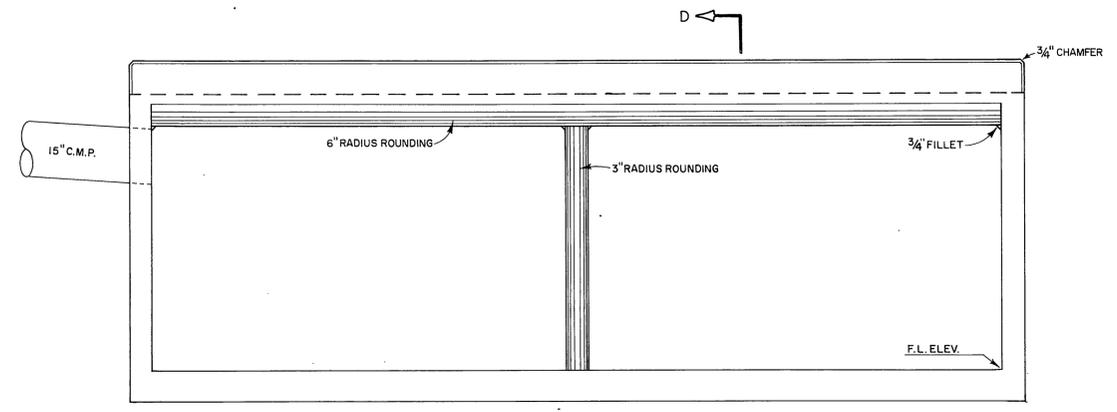

**VIEW B-B**  
SCALE: 1/2" = 1'-0"

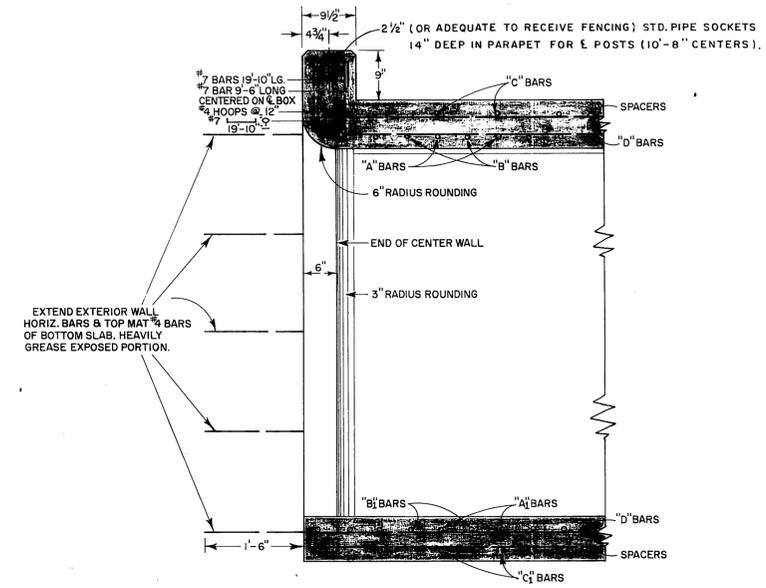

**SECTION D-D**  
SCALE: 3/4" = 1'-0"

REFERENCE	DESCRIPTION	APPROVED	DATE
	NO CONSTRUCTION CHANGES	<i>[Signature]</i>	11-28-66

— REVISIONS —

**RIVERSIDE COUNTY FLOOD CONTROL  
AND  
WATER CONSERVATION DISTRICT**

**DETAILS  
R.C. BOX CULVERT  
STA. 137+52.25**

AS BUILT  
PROJECT NO. 1-0-060

SURVEY NO. 3418  
FIELD BOOK NO. 913

APPROVED *[Signature]*  
COUNTY ROAD COMMISSIONER  
DATE March 12, 1964




APPROVED <i>[Signature]</i> COUNTY ENGINEER R.E. NO. 8822 DATE 11-9-64	DRAWN BY RIV. COUNTY ROAD DEPT. CHECKED BY DATE DRAWN	SHEET NO. 8 DR. NO. 1-182
--	--	------------------------------

**MISSING SHEET**


**MISSING SHEET**

**MISSING SHEET**


**MISSING SHEET**

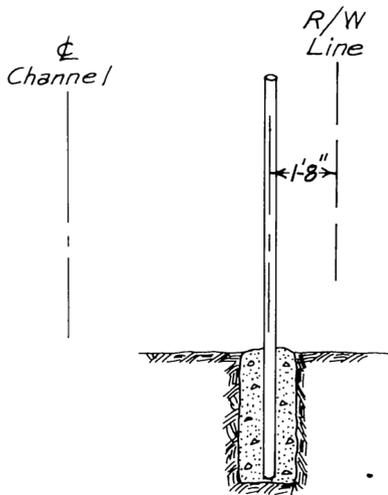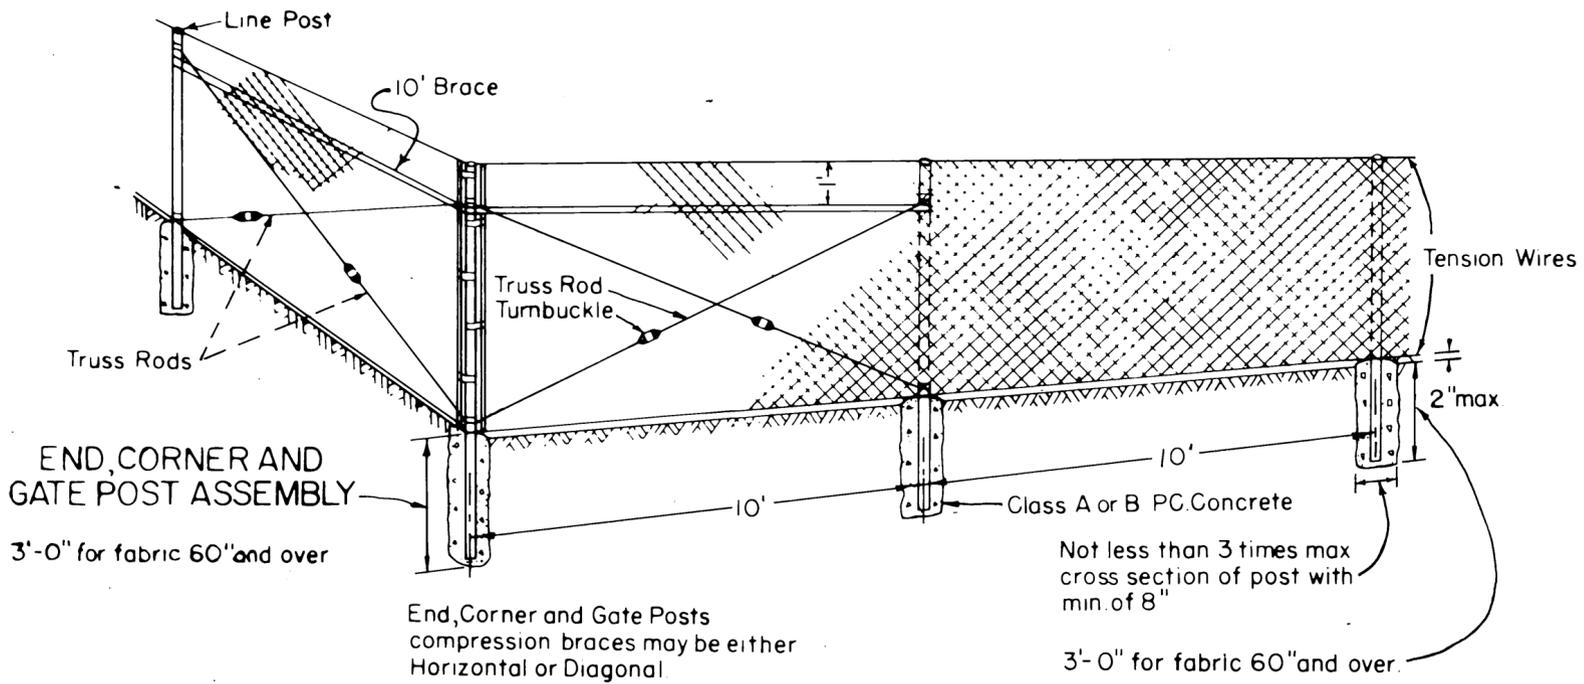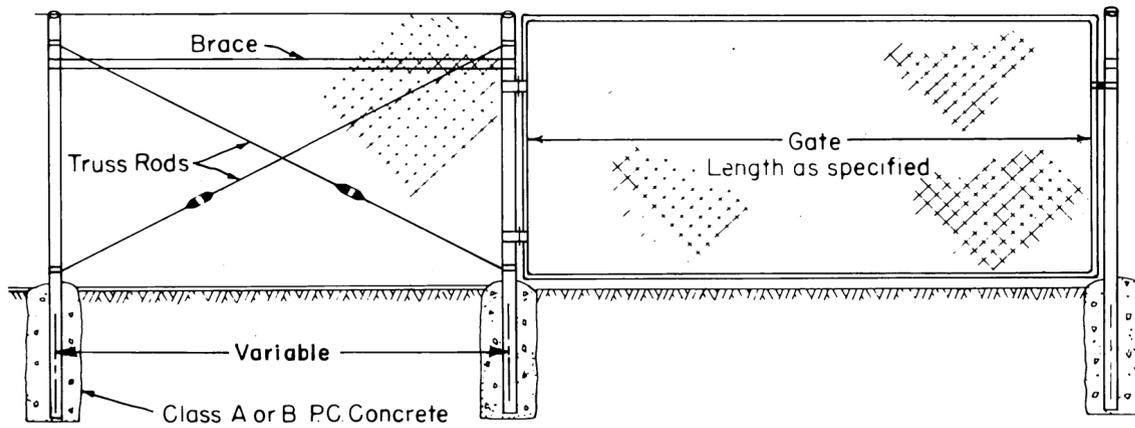

TYPICAL FOR WELLS AVE. MAINTENANCE RAMP APPROACH

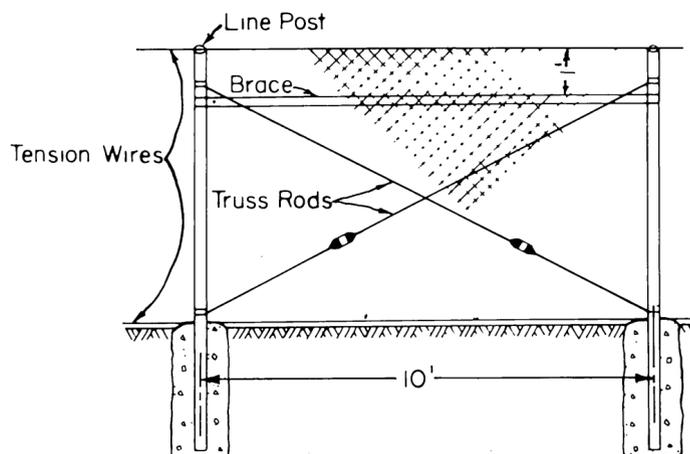

Line posts at 1,000' maximum intervals braced and trussed in both directions.

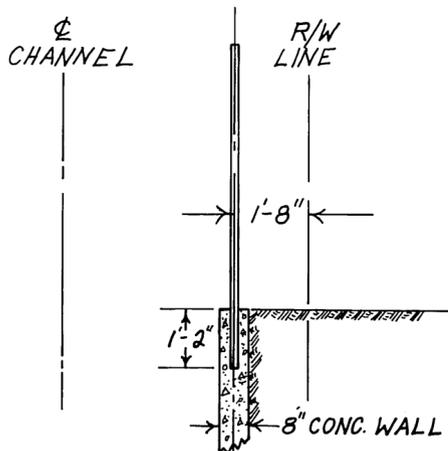

TYPICAL FOR CHANNEL WALLS

REVISED DATE	RIVERSIDE COUNTY FLOOD CONTROL AND WATER CONSERVATION DISTRICT	
	CHAIN LINK FENCE	
	Type CL-6 = 72" fabric	
APPROVED: <i>John W. Bryant</i> CHIEF ENGINEER A.E. NO. 8822	DRAWN: R. DAVIS	SHEET No. 13 of 19
DATE: 11-10-64	CHECKED:	DWG. No. 1-182
	DATE DRAWN: NOV. 1964	